



PLATE NO.1



CONFIDENTIAL

CORRECTED TO SUIT SHIP		
PLACE	DATE	OFFICER IN CHARGE
NAVY YARD, NEW YORK	OCT.10,1942	<i>H.E. Harberle</i>
" " " "	JAN 5, 1943	<i>H.E. Harberle</i>
" " " "	APRIL 1, 1943	<i>B.G. Pinner</i>
" " " "	JULY 1, 1943	<i>W. Henderson</i>
USNDD, HUNTER'S POINT, CALIF.	29 JUNE 1943	<i>W. Henderson</i>
PUGET SOUND NAVAL SHIPYARD	OCTOBER 1946	<i>W. Henderson</i>
NORFOLK NAVAL SHIPYARD, PORTSMOUTH, VA.	7/1/63	<i>W. Henderson</i>
NORFOLK NAVAL SHIPYARD - PLAN CORRECTED TO SUIT C.O. LTR	7/9/56	<i>W.R. Carlson / WHP</i>
CORRECTED TO SUIT 1964 REACTIVATION & MODERNIZATION		
CDI MARINE CO.		

ORDER OF PLANS	
TITLE	PLATE NO.
COVER SHEET	1
GENERAL DIMENSIONS & DATA	2
OUTBOARD PROFILE	3
INBOARD PROFILE	4
BRIDGES	5
FIRST & SECOND SUPERSTRUCTURE DECKS	6
MAIN DECK	7
SECOND DECK	8
SPLINTER DECK	9
THIRD DECK	10
FIRST PLATFORM	11
SECOND & THIRD PLATFORMS	12
HOLD	13
THIRD BOTTOM	14
INNER BOTTOM	15
SECTIONS	16,17 & 18

SELECTED RECORD DRAWING

SERIAL NO. BB61

CONFIDENTIAL

PER OPNAV INST S5513.3A
ENCLOSURE 17 JD 03A-17

REVIEW FOR DECLASSIFICATION ON: 10 JAN 1995

DECLASSIFY ON: OADR

BOOKLET
OF
GENERAL PLANS

PREPARED AT THE
NAVY YARD, NEW YORK

FORMERLY BU. NO. 355817

BU. NO. 578106

LENGTH OVER ALL (MOLDED)	887
LENGTH BETWEEN PERPENDICULARS	860
BREADTH, EXTREME, TO OUTSIDE OF PLATING	108
DRAFT, CORRESPONDING TO TRIAL DISPLACEMENT	

	ABV
HEIGHT OF MAIN DECK AT STEM	69'
HEIGHT OF MAIN DECK AT STERN	56'
HEIGHT OF 1ST SUPERSTRUCTURE	60'
HEIGHT OF 2ND SUPERSTRUCTURE	68'
HEIGHT OF FLAG AND SIGNAL BRIDGE	75'
HEIGHT OF NAVIGATING BRIDGE	83'
HEIGHT OF PILOT HOUSE TOP	90'
HEIGHT OF 1ST LEVEL - FORWARD	98'
HEIGHT OF 2ND LEVEL - FORWARD	105'
HEIGHT OF 3RD LEVEL - FORWARD	113'
HEIGHT OF 4TH LEVEL - FORWARD	121'
HEIGHT OF 5TH LEVEL - FORWARD	129'
HEIGHT OF 6TH LEVEL - FORWARD	138'

MOLDED BASE LINE OF SHIP IS 2" ABOVE BOTTOM OF KEE

MASTS & LIGHTS

HEIGHT OF FWD ANCHOR LIGHT (WHITE)	58'-4 ³ / ₄ "
HEIGHT OF AFT ANCHOR LIGHT (WHITE)	43'-7 ¹ / ₂ "
FWD MASTHEAD LIGHT (WHITE)	72'-7 ⁸ / ₁₆ "
AFT MASTHEAD LIGHT (WHITE)	128'-5 ³ / ₁₆ "
SIDELIGHTS P/s (P-RED, S-GREEN)	28'-5 ³ / ₁₆ "
UPPER MOD. ACFT WRN & SHIPS TASK LTS (DUAL ARRAY) (RED)	67'-5 ³ / ₄ "
MIDDLE MOD & SHIP'S TASK LTS (DUAL ARRAY) (WHITE)	58'-11 ¹ / ₄ "
LOWER MOD & SHIP'S TASK LTS (DUAL ARRAY) (RED)	50'-5 ³ / ₄ "
HOMING BEACON (WHITE)	147'-9 ³ / ₄ "
BLINKER LIGHTS P/s (WHITE)	125'-8 ³ / ₄ "
WAKE LIGHT (WHITE SPOT LT)	25'-0 ³ / ₄ "
STERN LIGHT (WHITE)	24'-0 ¹ / ₄ "
STERN LIGHT (BLUE)	22'-10 ¹ / ₄ "
STEERING LIGHT (WHITE)	45'-11"


TOTAL 1820

CONFIDENTIAL

BB61 - PLATE 2 OF 18

CONFIDENTIAL




CONFIDENTIAL

 


INBOARD PROFILE
BU. NO. 578106
SCALE: 1/16" = 1'-0"
PLATE 4 OF 18

CONFIDENTIAL


CONFIDENTIAL

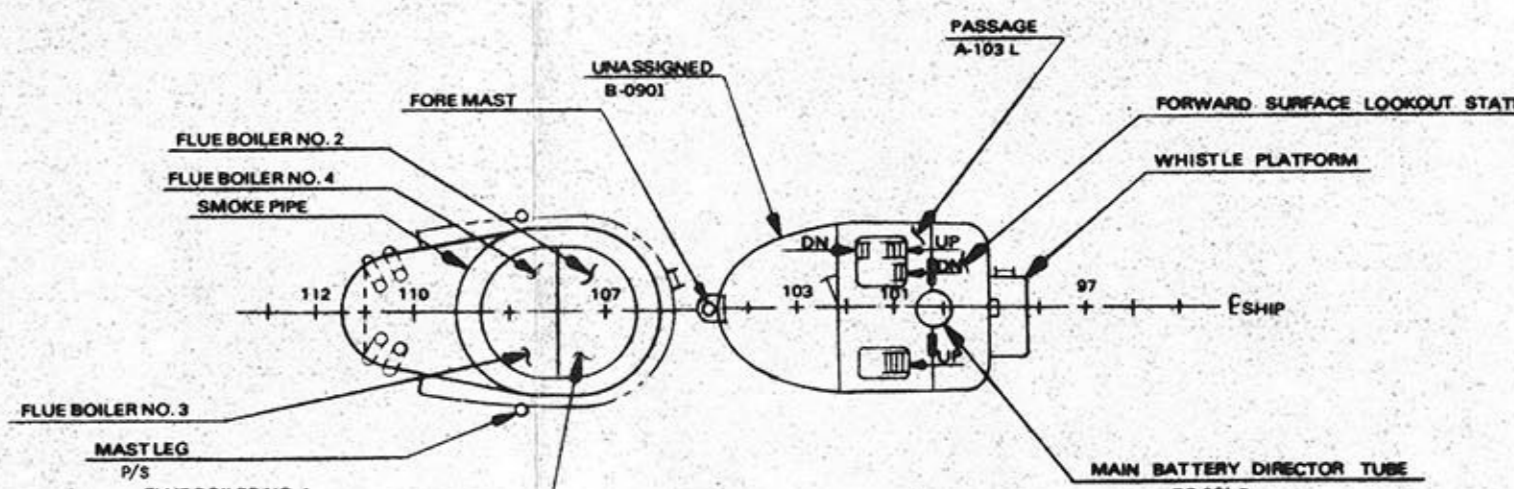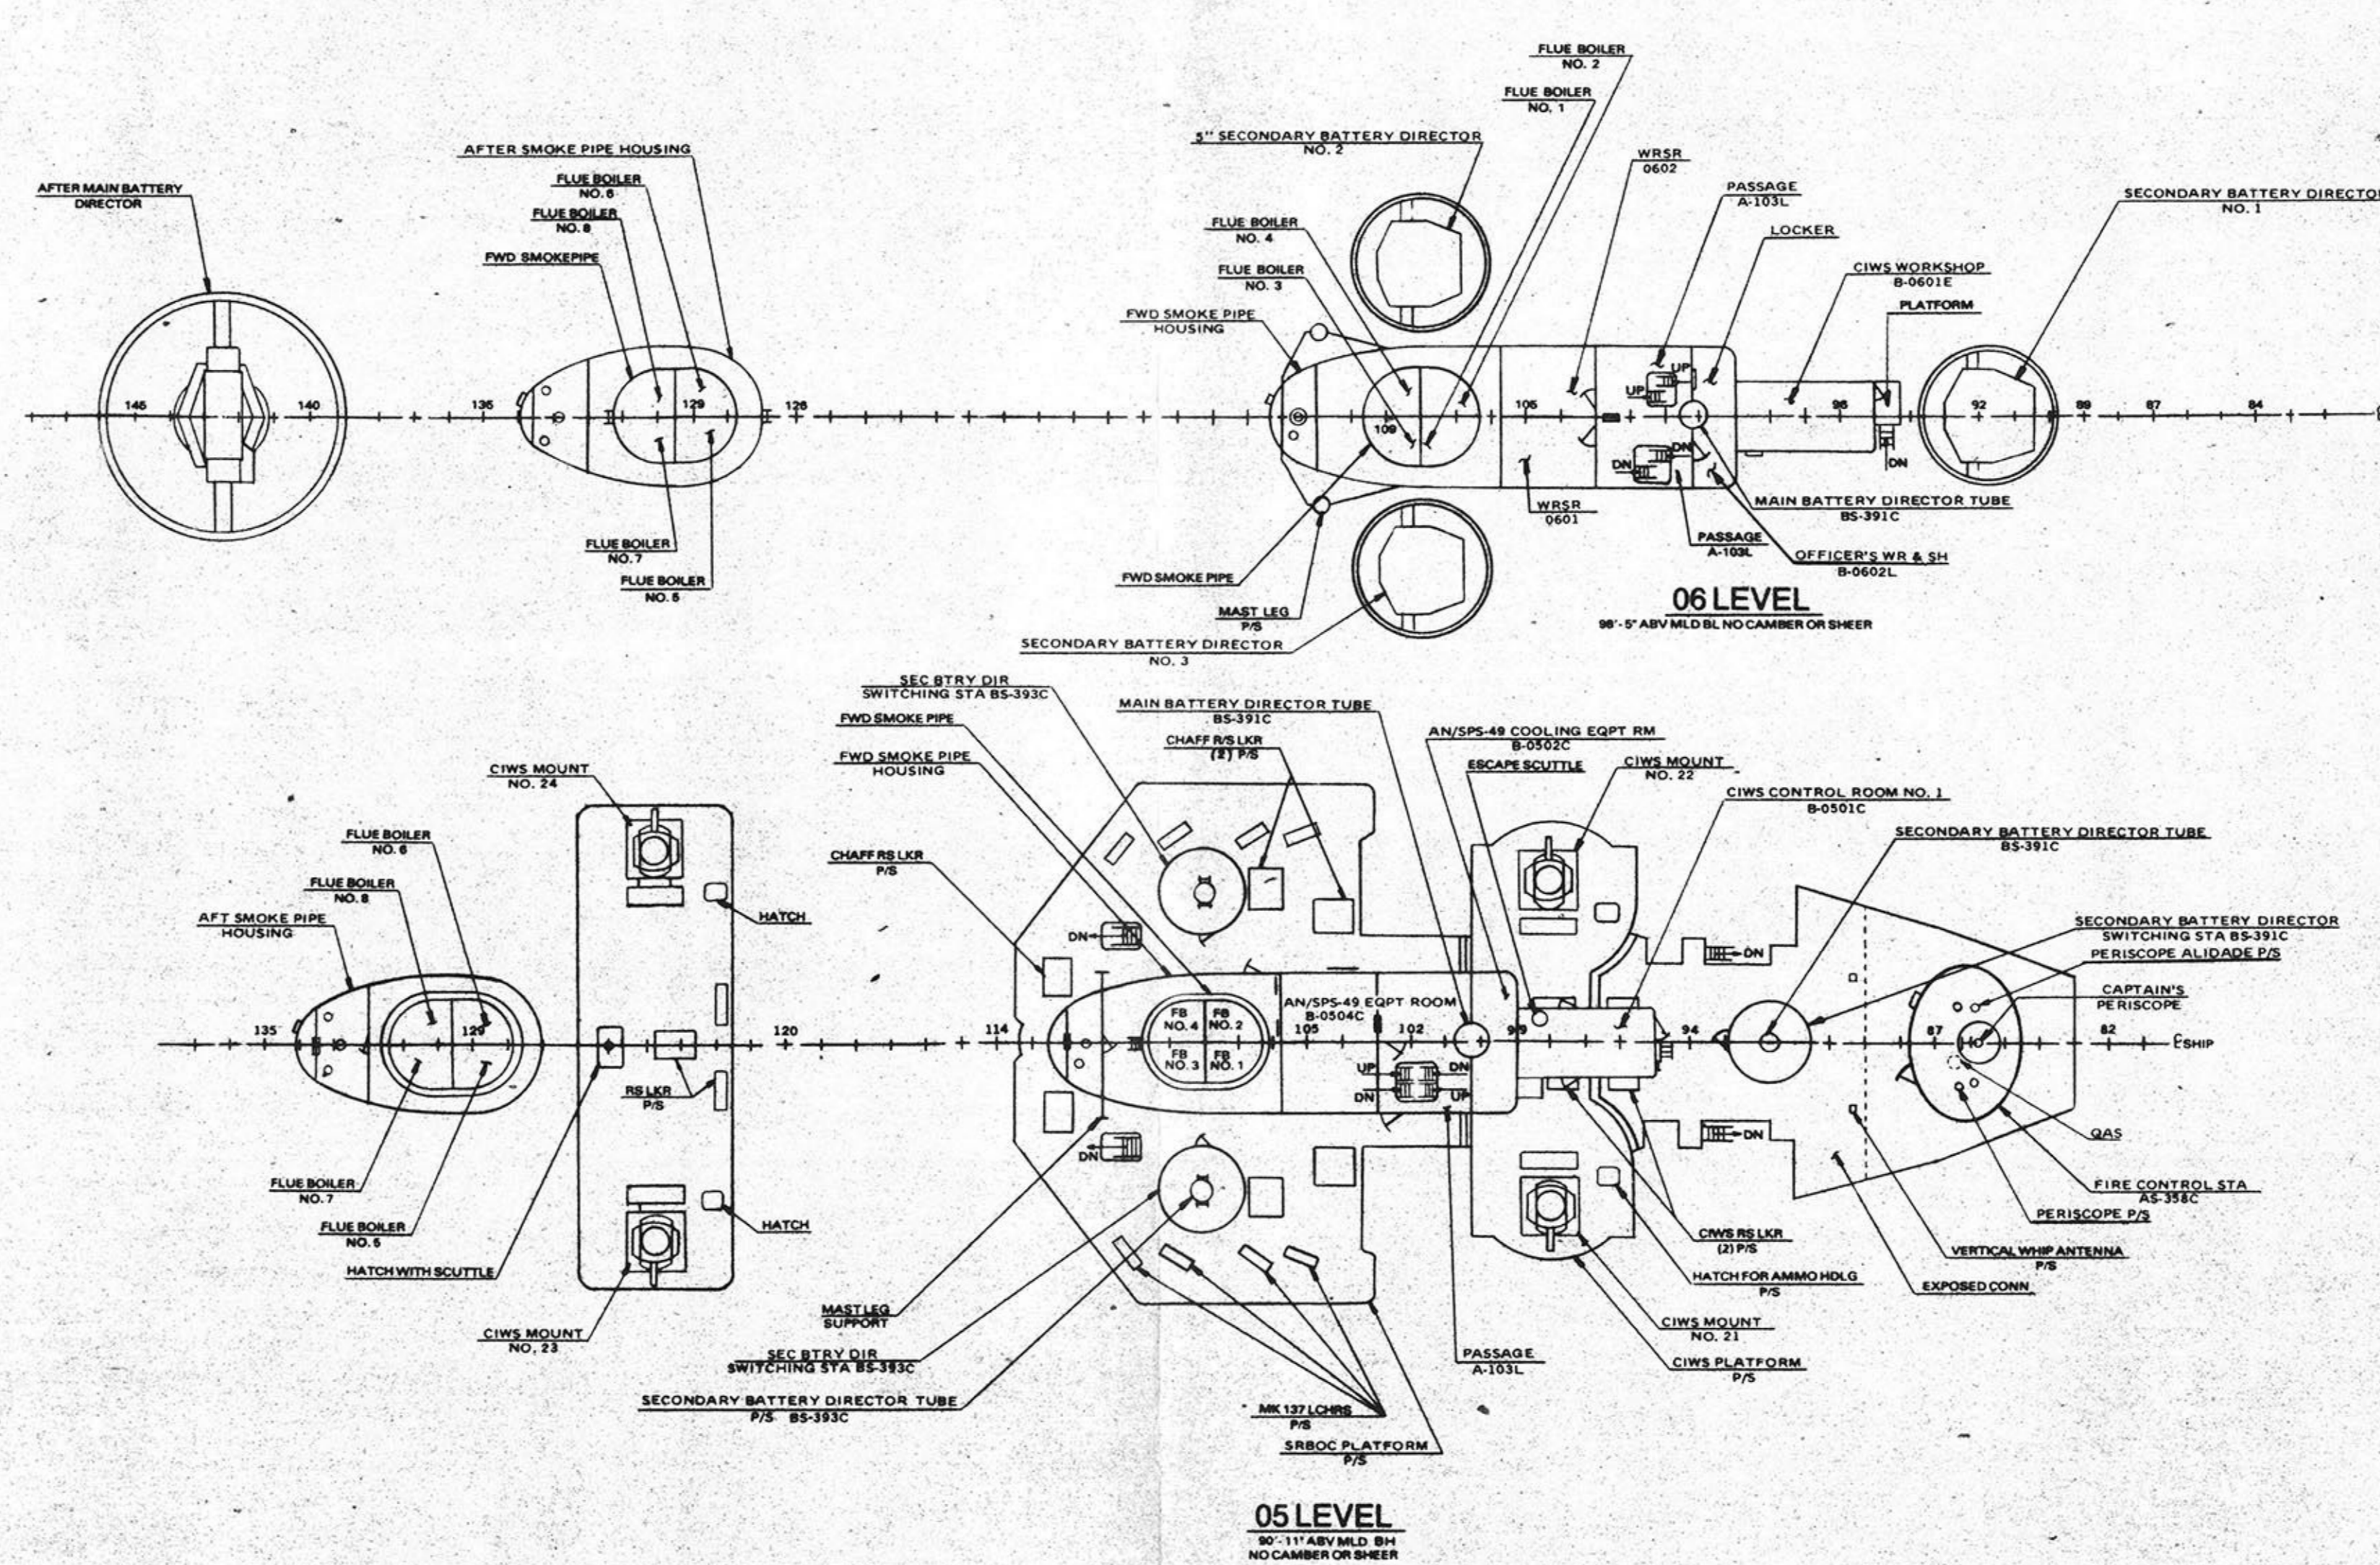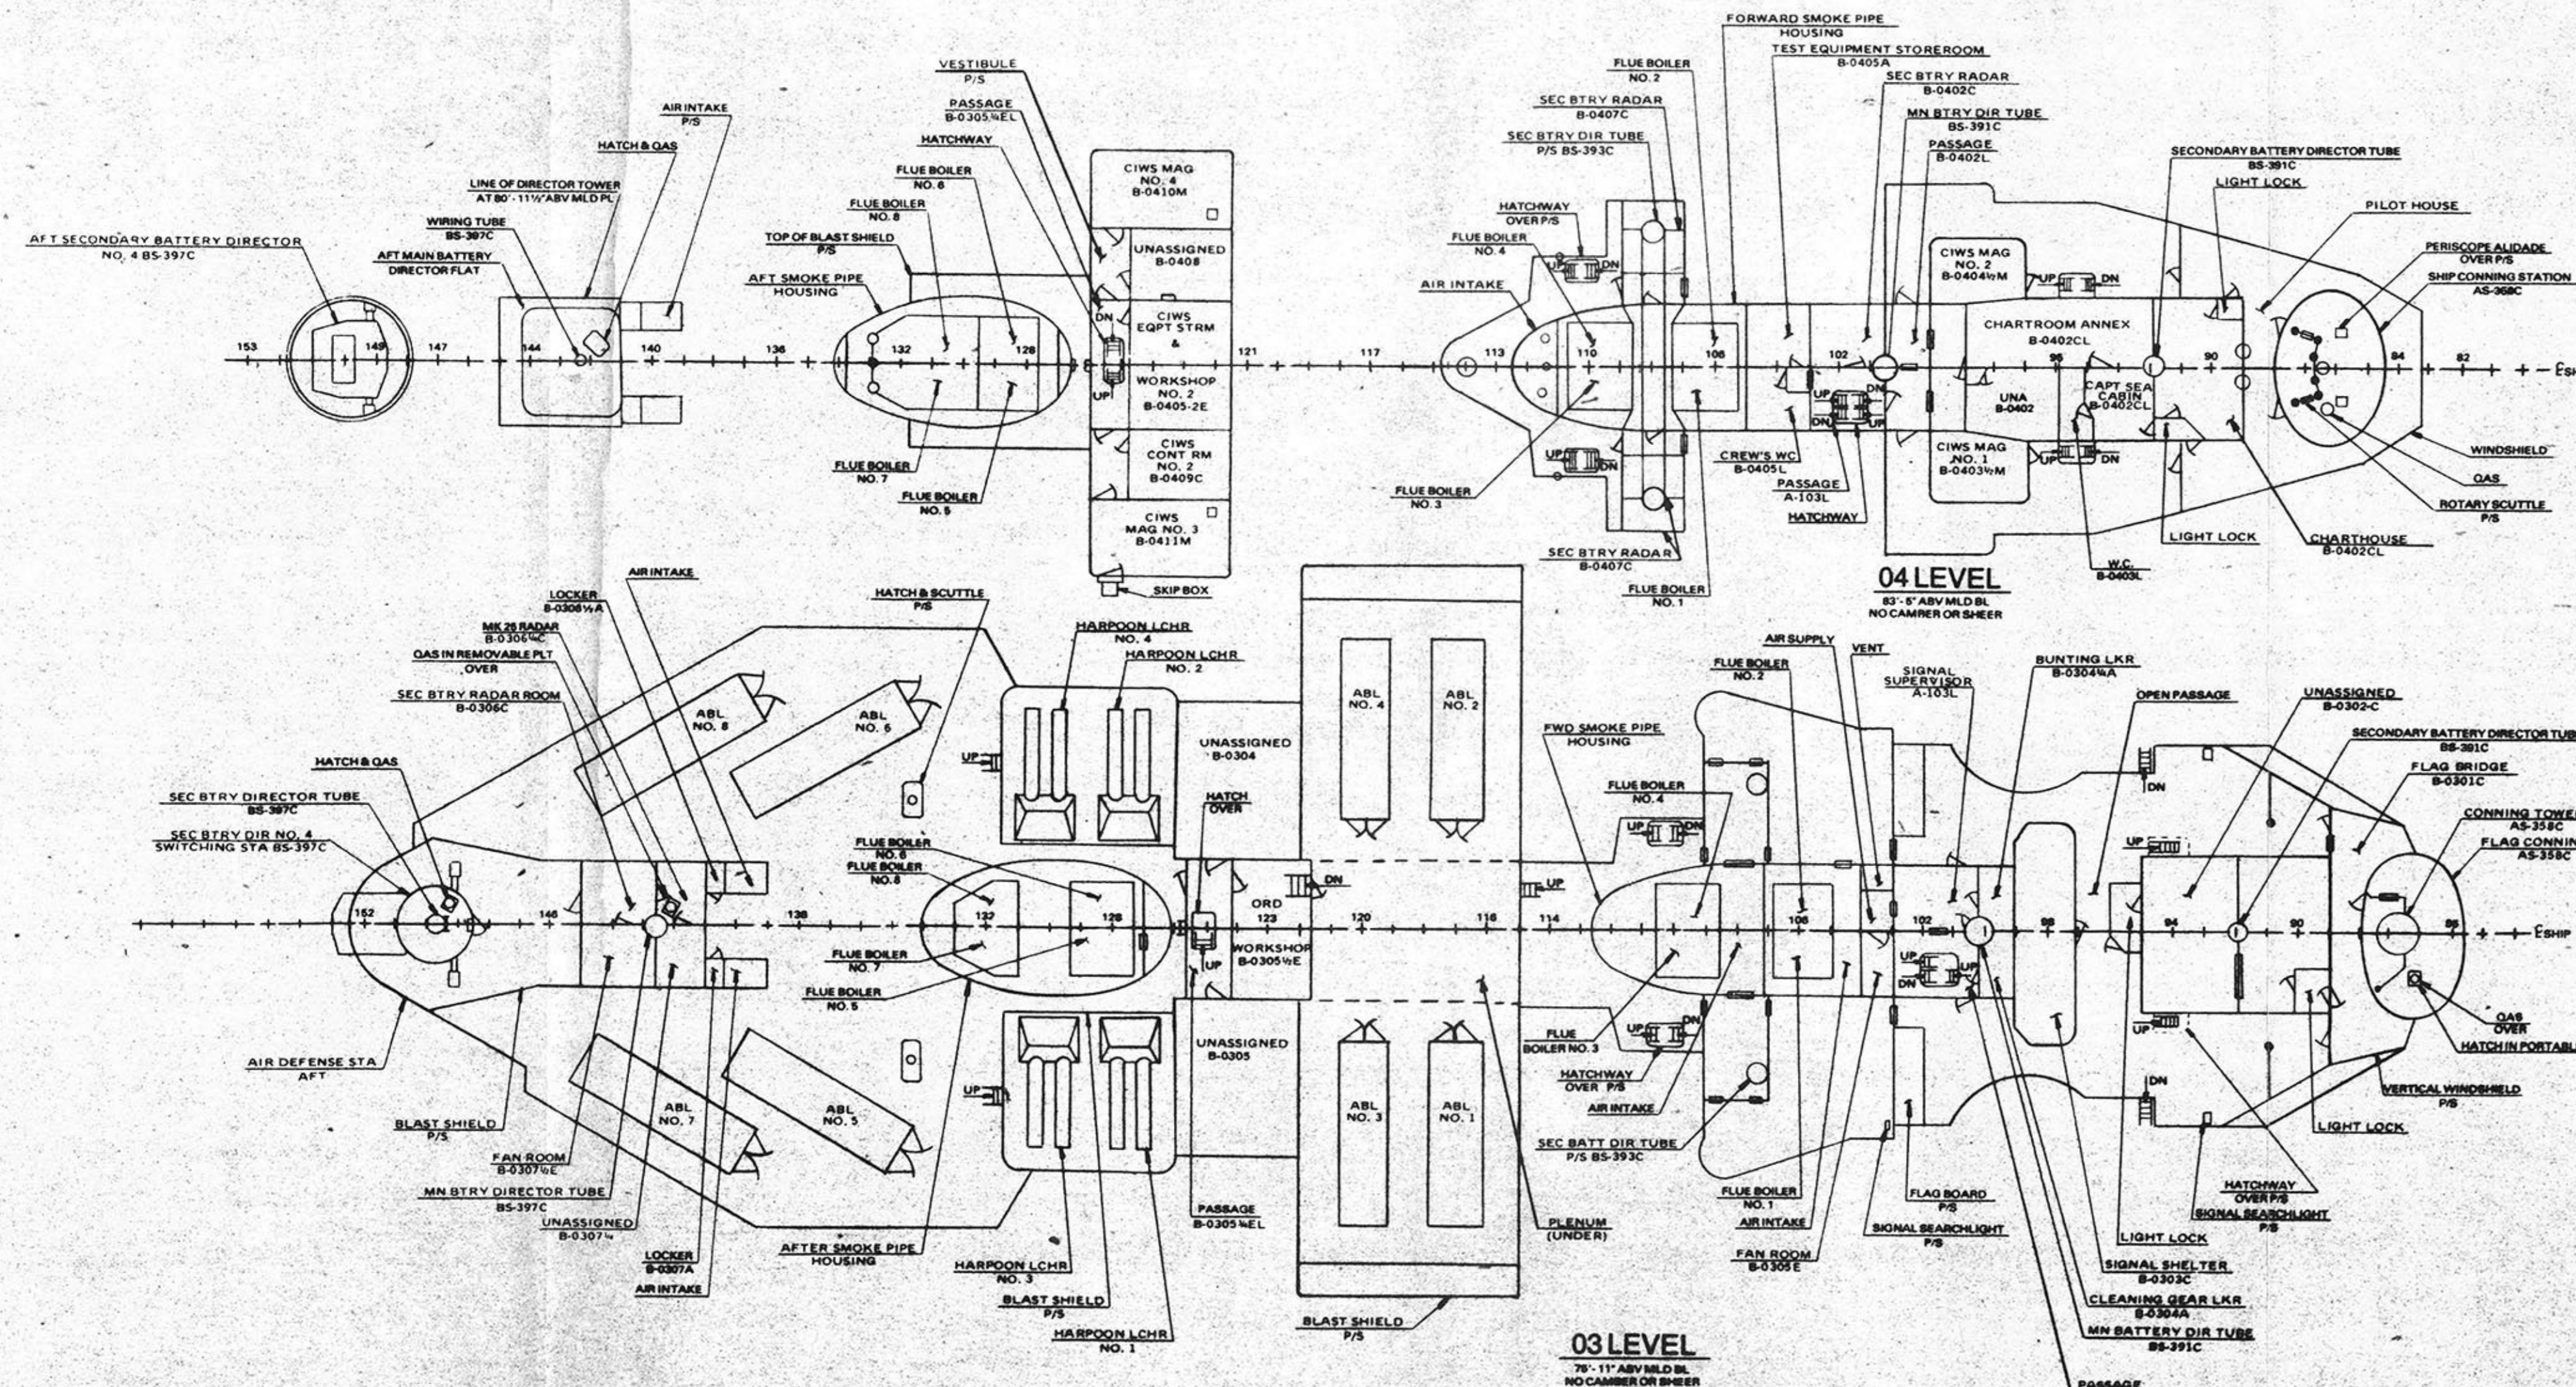


09 LEVEL
121'-7" ABV MLD BL NO CAMBER OR SHEER

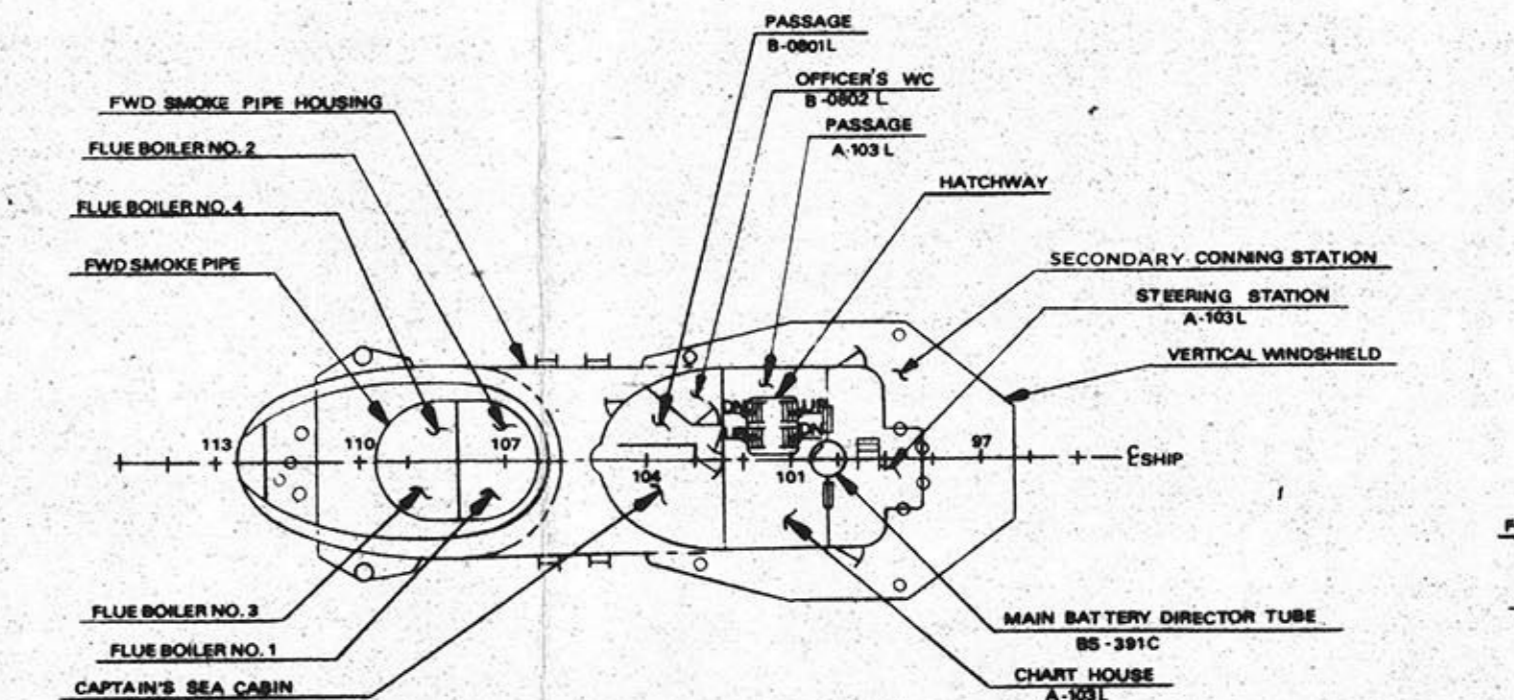


08 LEVEL
113'-8" ABV MLD BL NO CAMBER OR SHEER

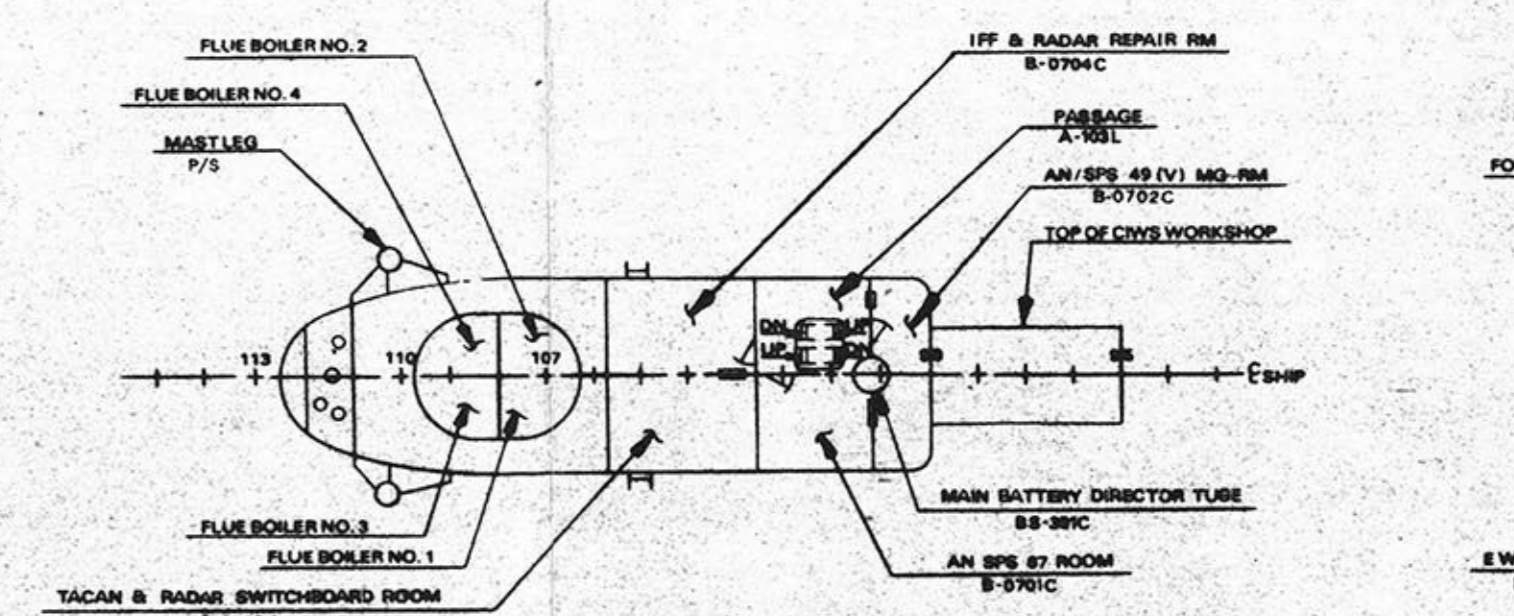

07 LEVEL
108'-11" ABV MLD BL NO CAMBER OR SHEER

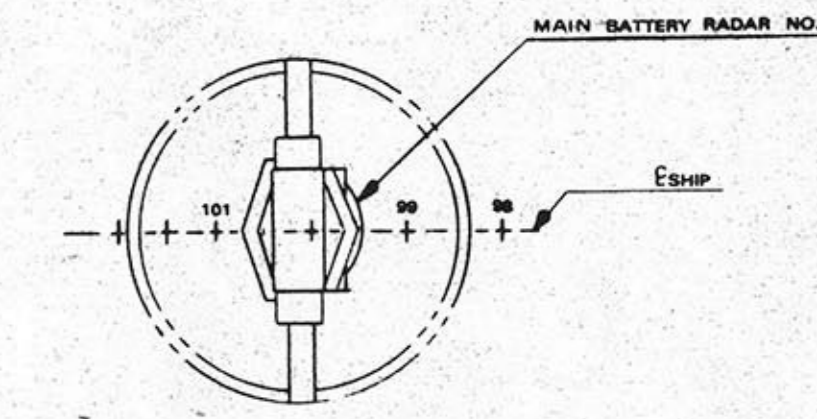


011 LEVEL
138'-0" ABV MLD BL NO CAMBER OR SHEER

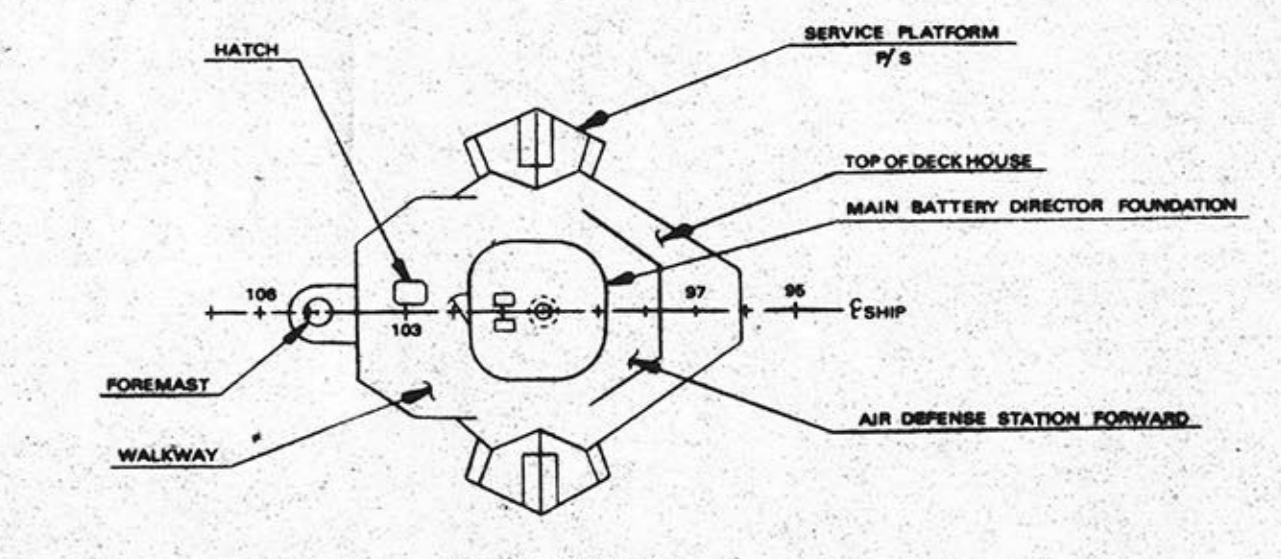

010 LEVEL
128'-5" ABV MLD BL NO CAMBER OR SHEER

BRIDGES
BU. NO. 578106
SCALE: 1/16"=1'-0"
PLATE 5 OF 18

CONFIDENTIAL

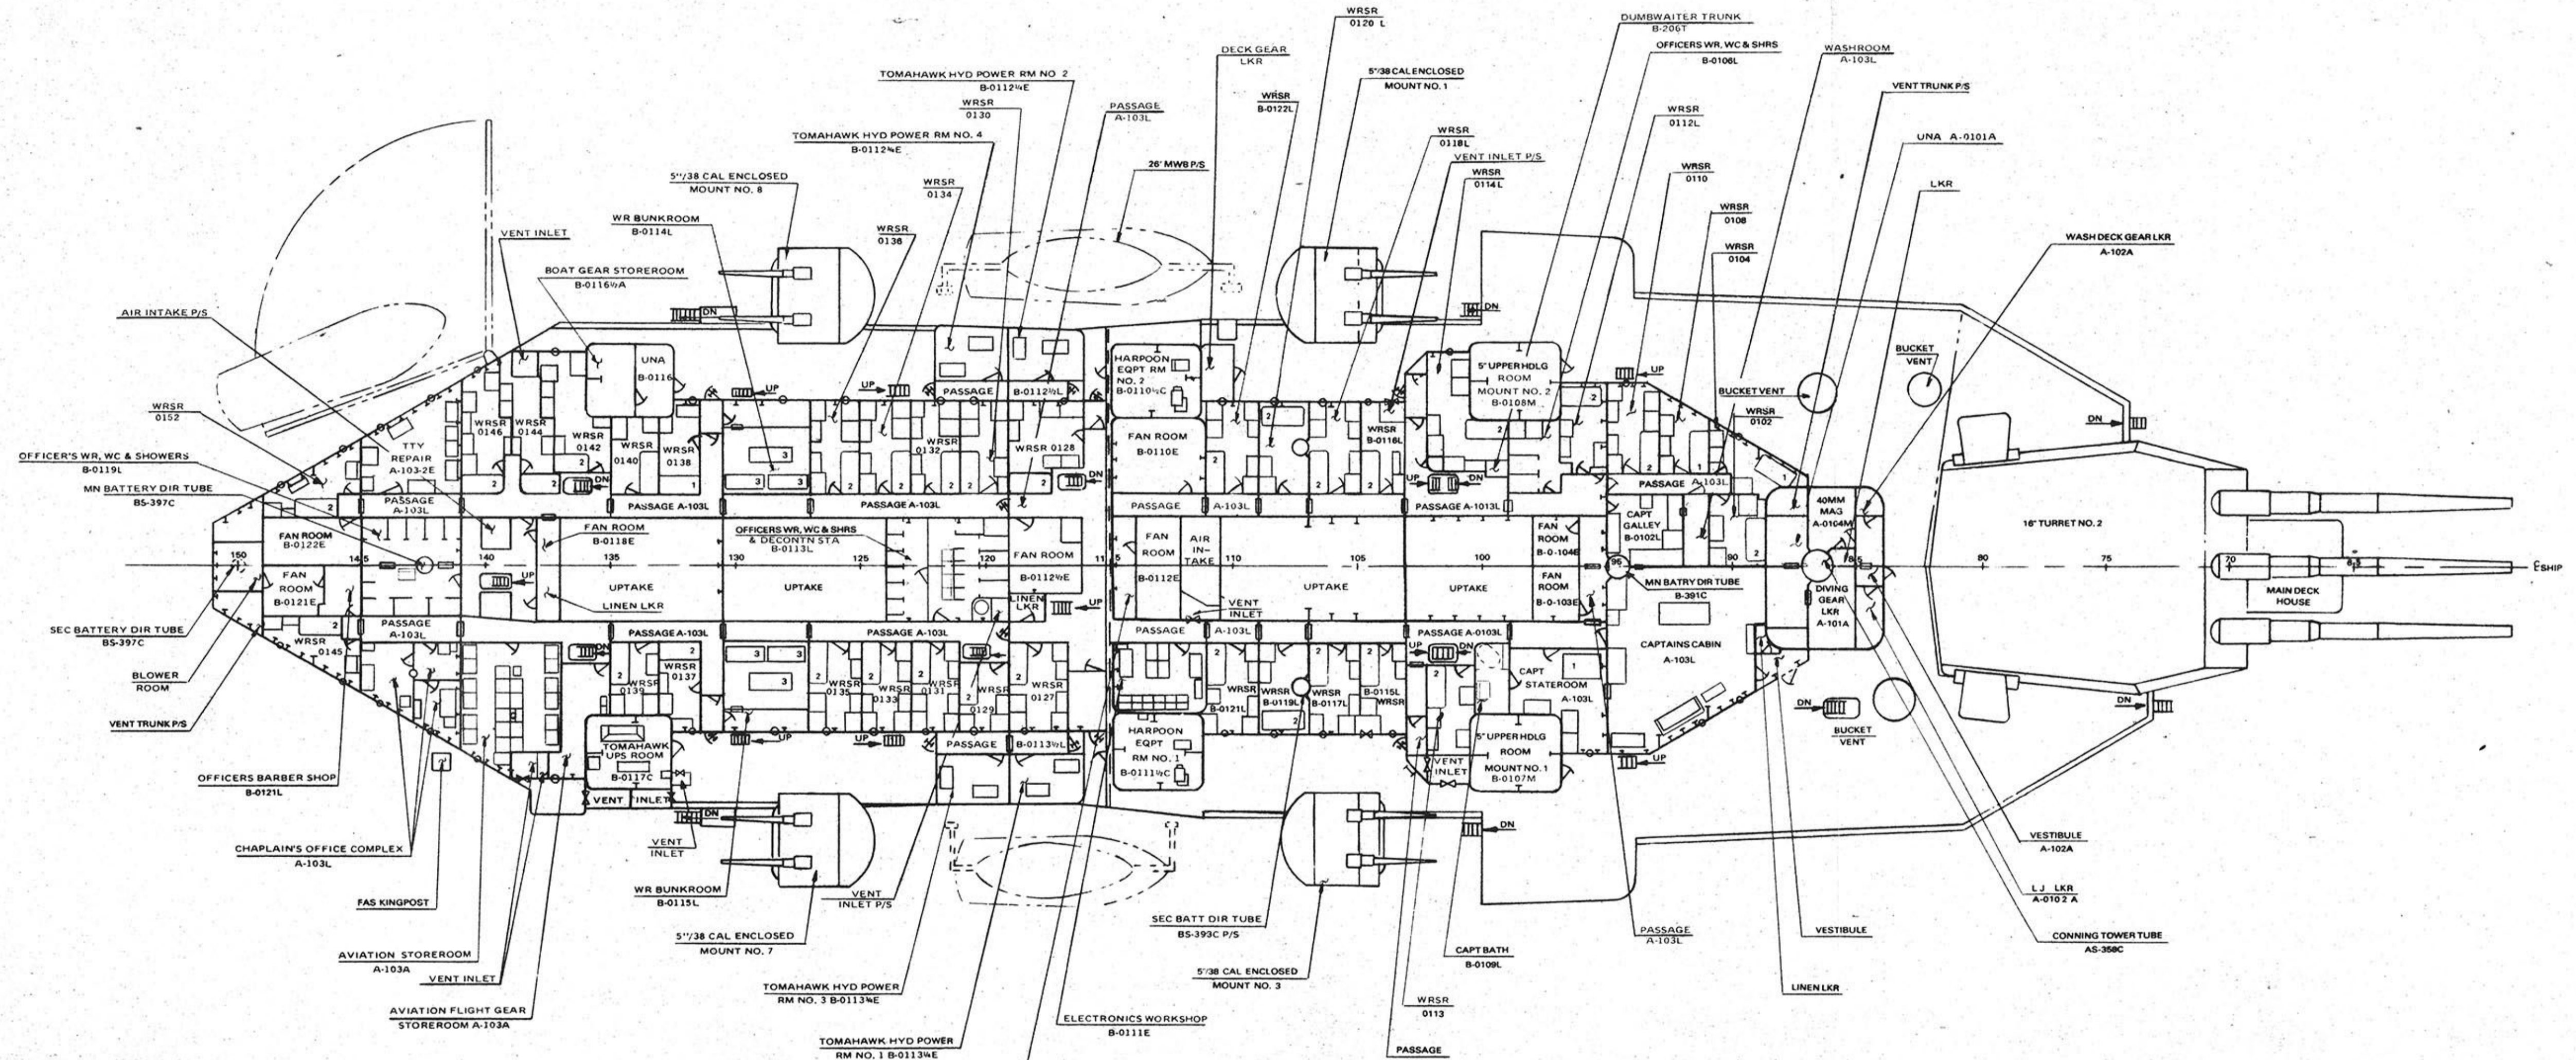


01 LEVEL

FIRST AND SECOND
SUPERSTRUCTURE DECKS
BU. NO. 578106
SCALE : 1/16" = 1'-0"
PLATE 6 OF 18

CONFIDENTIAL

CONFIDENTIAL

 


MAIN DECK

BU. NO. 578106
SCALE: 1/16"=1'-0"

PLATE 7 OF 18


CONFIDENTIAL

CONFIDENTIAL

 


SECOND DECK
BU. NO. 578106
SCALE: 1/16" = 1'-0"
PLATE 8 OF 18

CONFIDENTIAL

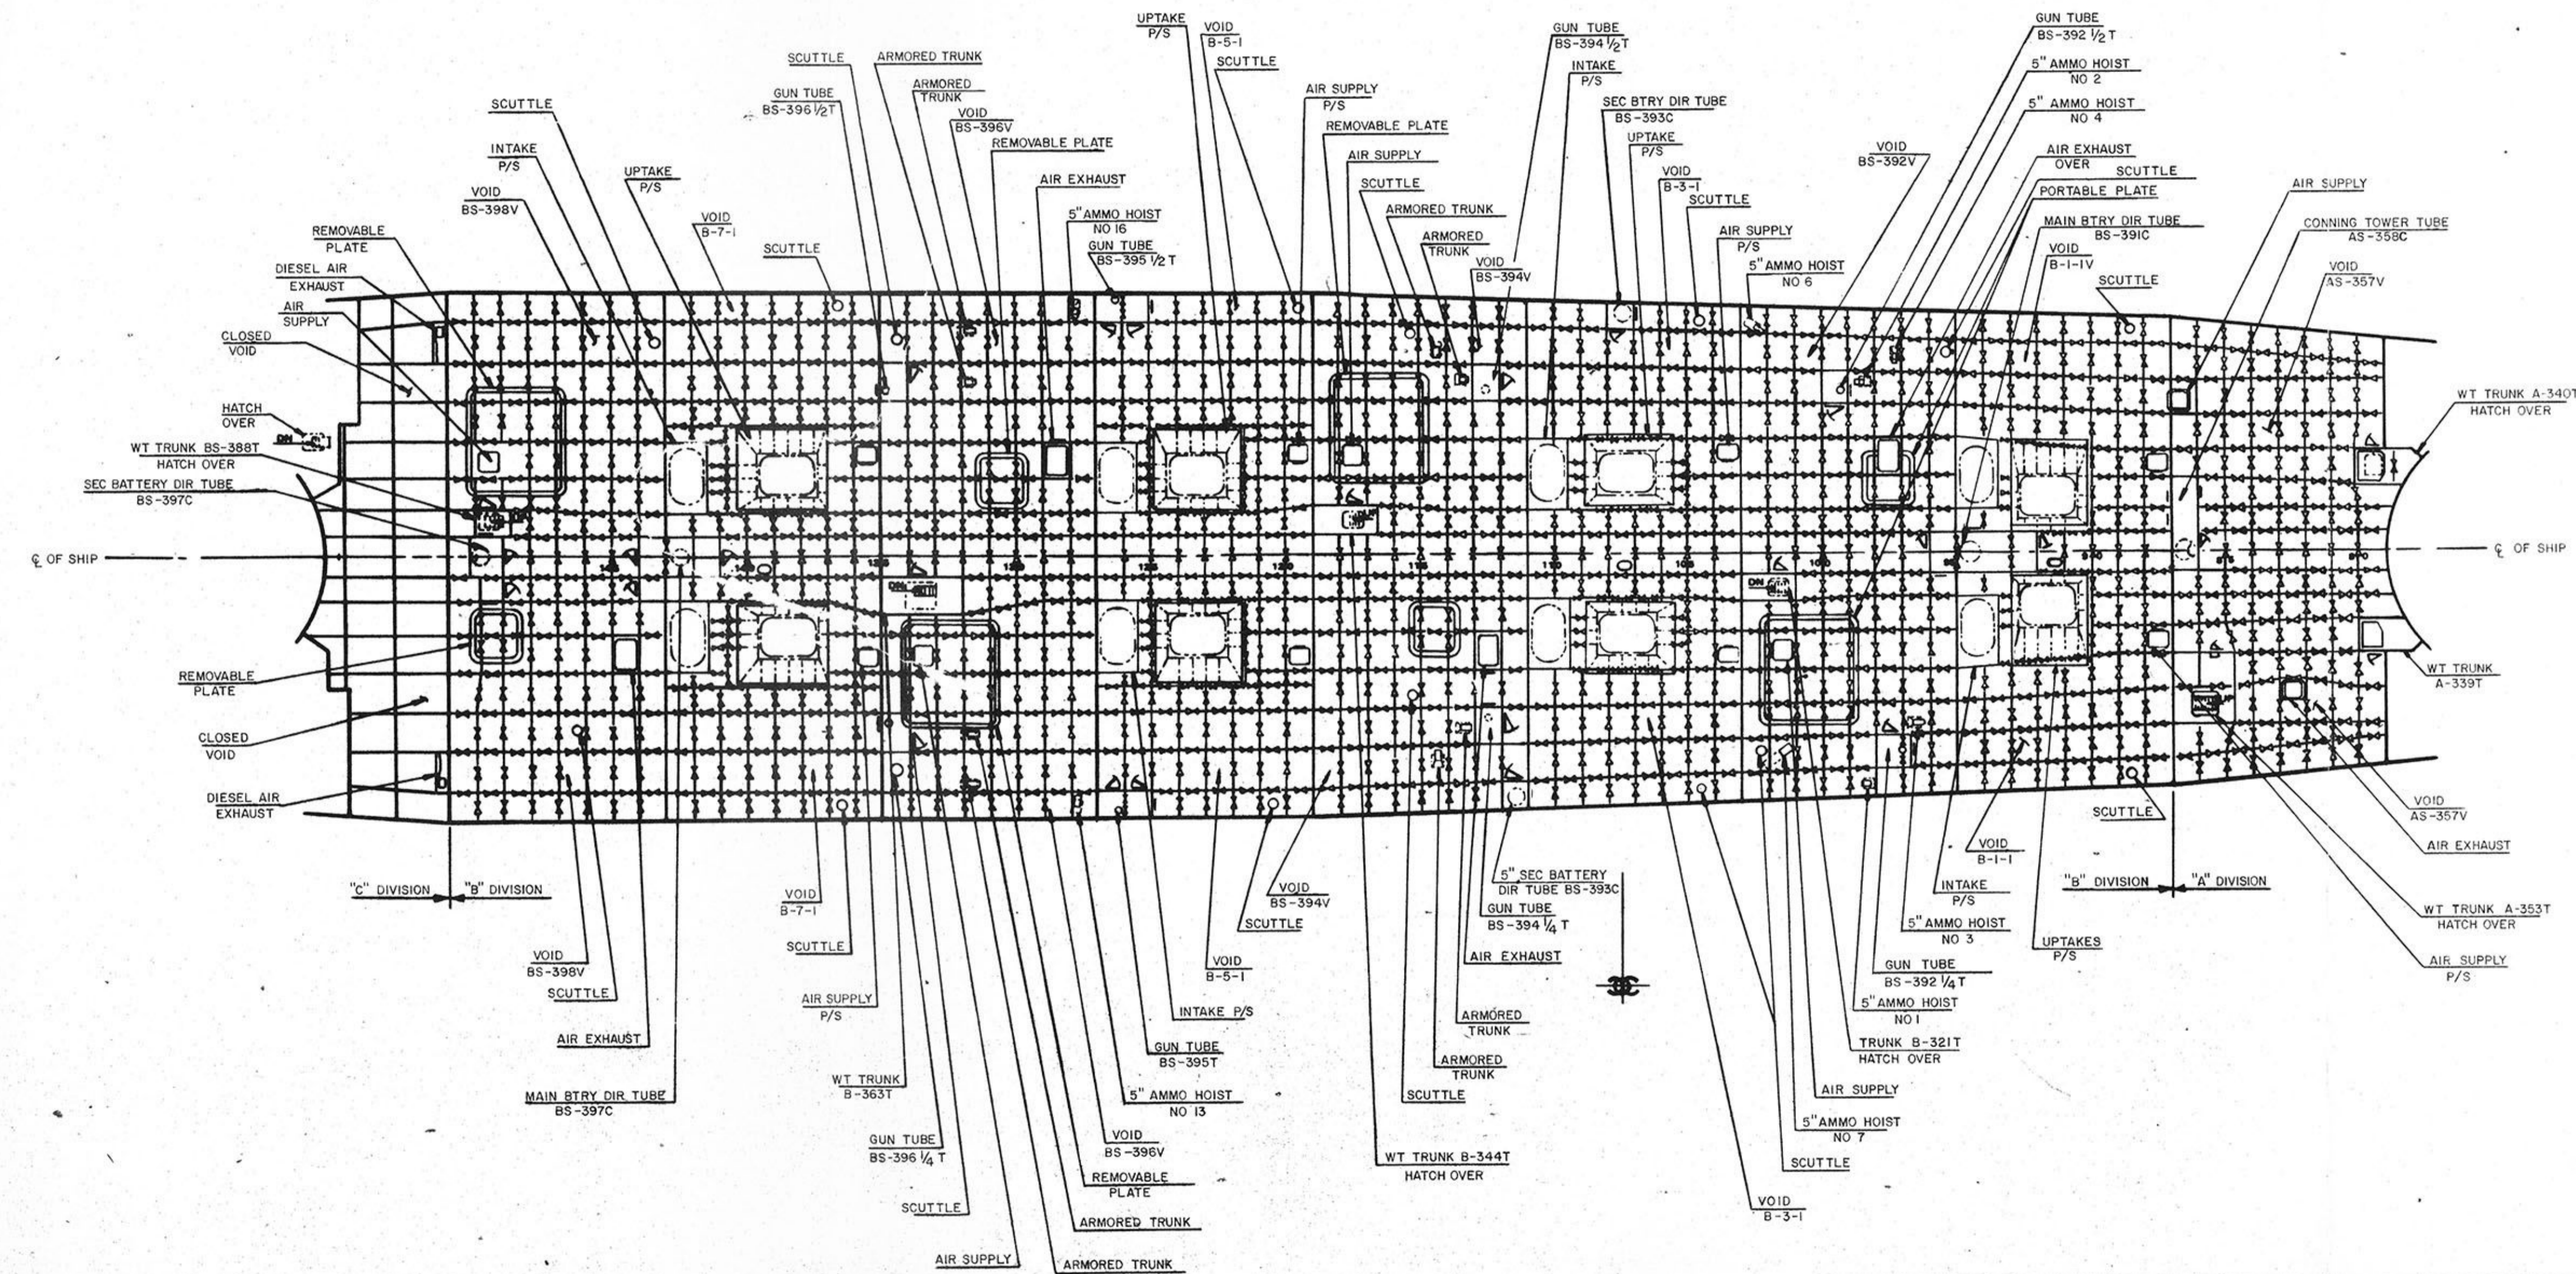

SPLINTER DECK
BU. NO. 578106
SCALE: 1/16"=1'-0"
PLATE 9 OF 18


CONFIDENTIAL

 

THIRD DECK
BU.NO. 578106
SCALE: 1/16"=1'-0"
PLATE 10 OF 18

CONFIDENTIAL


CONFIDENTIAL

 


FIRST PLATFORM
BU. NO. 578106
SCALE: 1/16" = 1'-0"
PLATE 11 OF 18

CONFIDENTIAL

CONFIDENTIAL

 

SECOND AND THIRD
PLATFORMS
BU. NO. 578106
SCALE: 1/16"=1'-0"
PLATE 12 OF 18

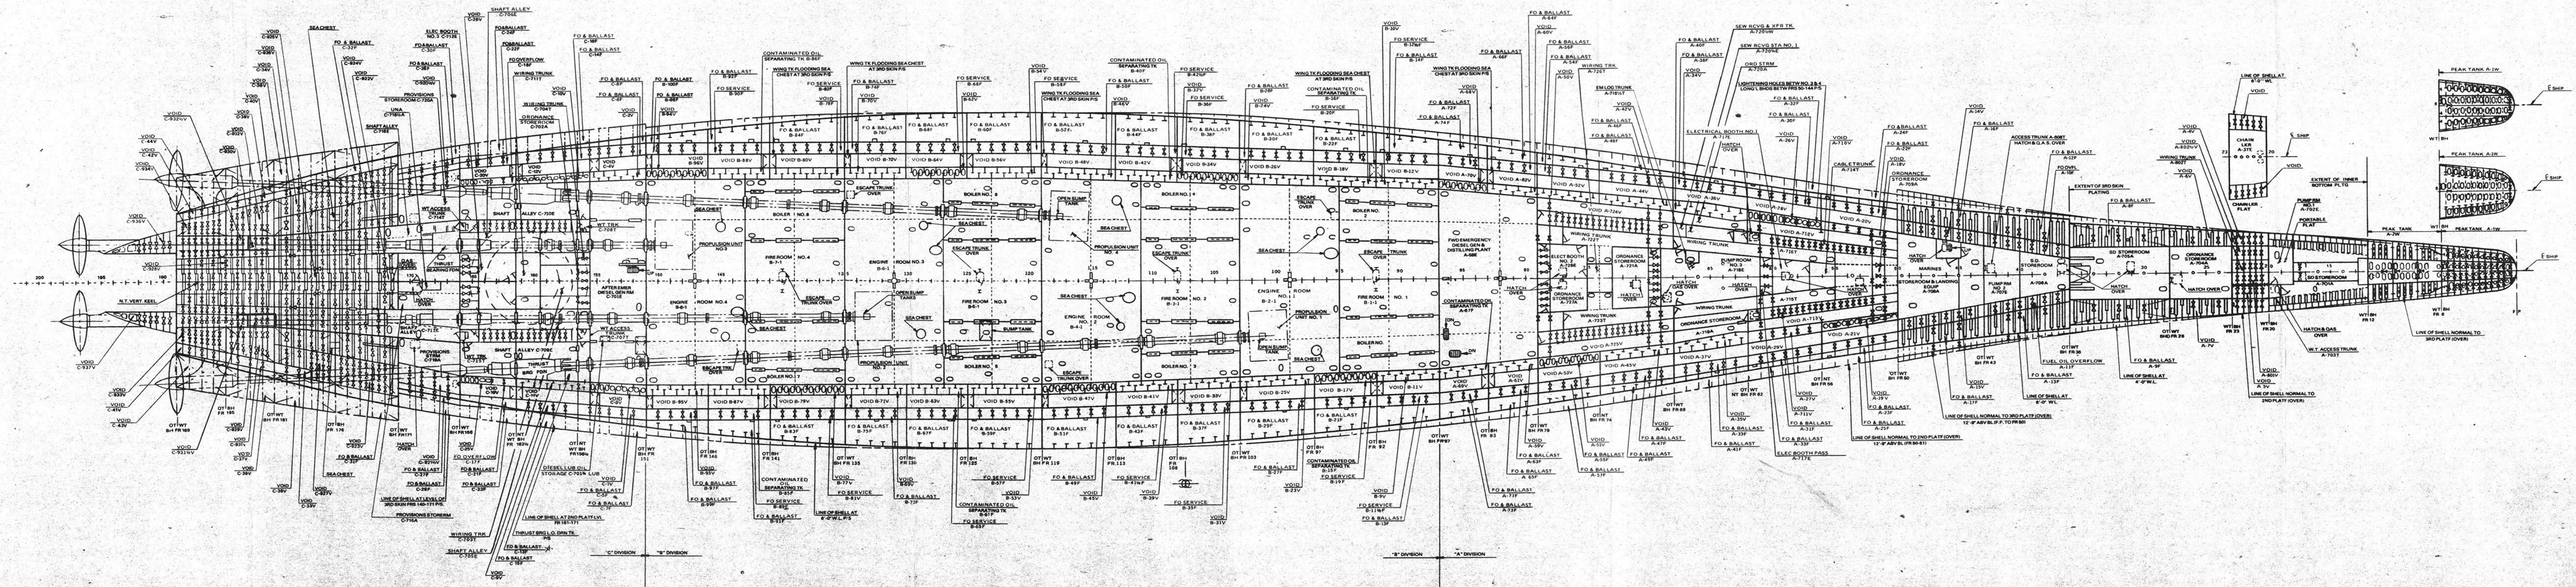

CONFIDENTIAL

